

A

# Ramirent AB

## SATCON T A-F 1000KV A

B

C

D

E

F

G

H




OSLO MOELV  
Tlf.22 57 93 00 Tlf.62 33 44 30

Ramirent AB  
SAT(ON TAF 1000k VA  
Ombygging av 65242  
22/11kV//1kV 50Hz




JOB NUMBER  
65242

DRAWING NUMBER  
65242

<b>DRAWN</b>	ES	<b>DESIGNED</b>	ES	<b>APPROVED</b>	
<b>PAPER SIZE</b>	A4	<b>SCALE</b>		<b>SHEET</b>	1X01
<b>DATE</b>	05.01.2007	<b>REV.</b>	05.01.2007	<b>CONT SH.</b>	

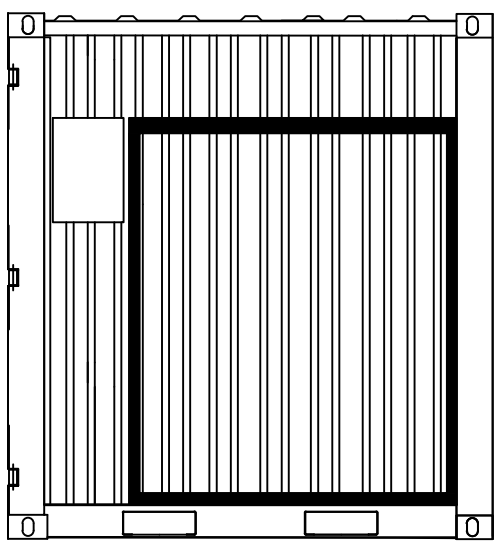

SETT FRA SIDEN

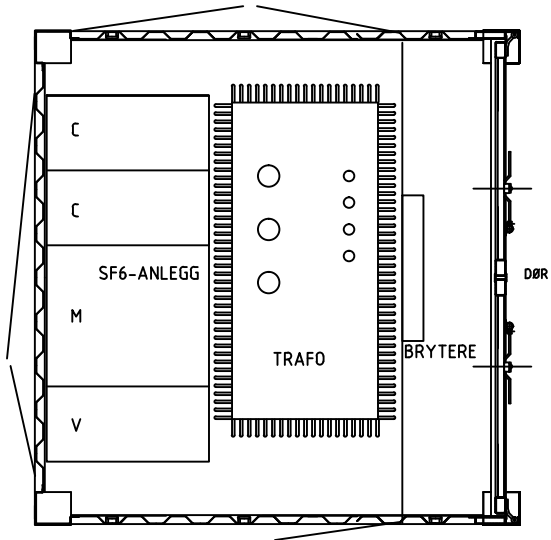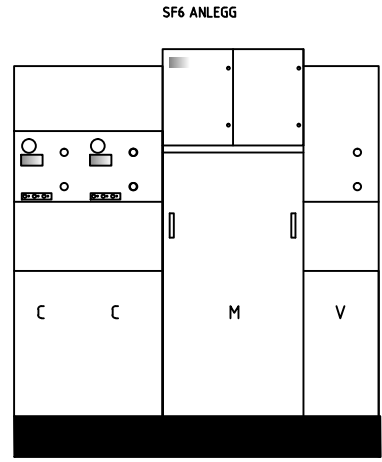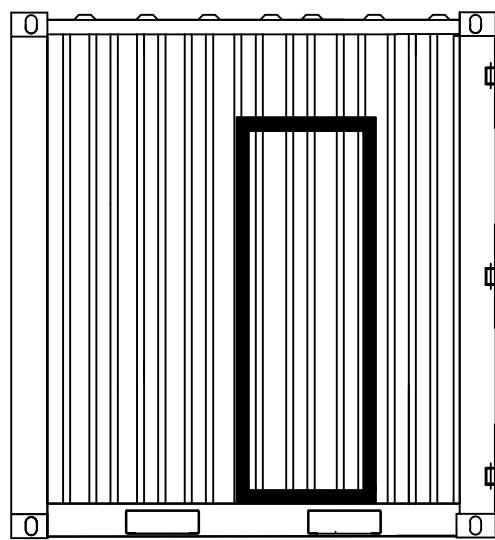

REV.	DESCRIPTION	DATE	DWN	REV.SIGN
B	ASBUILT		ES	ES
A	PROOUKSJON		ES	ES

**SATEMA**  
 OSLO Tlf.22 57 93 00      MOELV Tlf.62 33 44 30

Ramirent AB  
 SAT(ON TAF 1000k VA  
 Ombygging av 65242  
 22/11kV//1kV 50Hz

JOB NUMBER 65242		DRAWING NUMBER 65242		
DRAWN	ES	DESIGNED	ES	APPROVED
PAPER SIZE	A4	SCALE		SHEET 1X01
DATE	05.01.2007	REV.	05.01.2007	CONT SH.

A

B

C


D

E

F

G

H

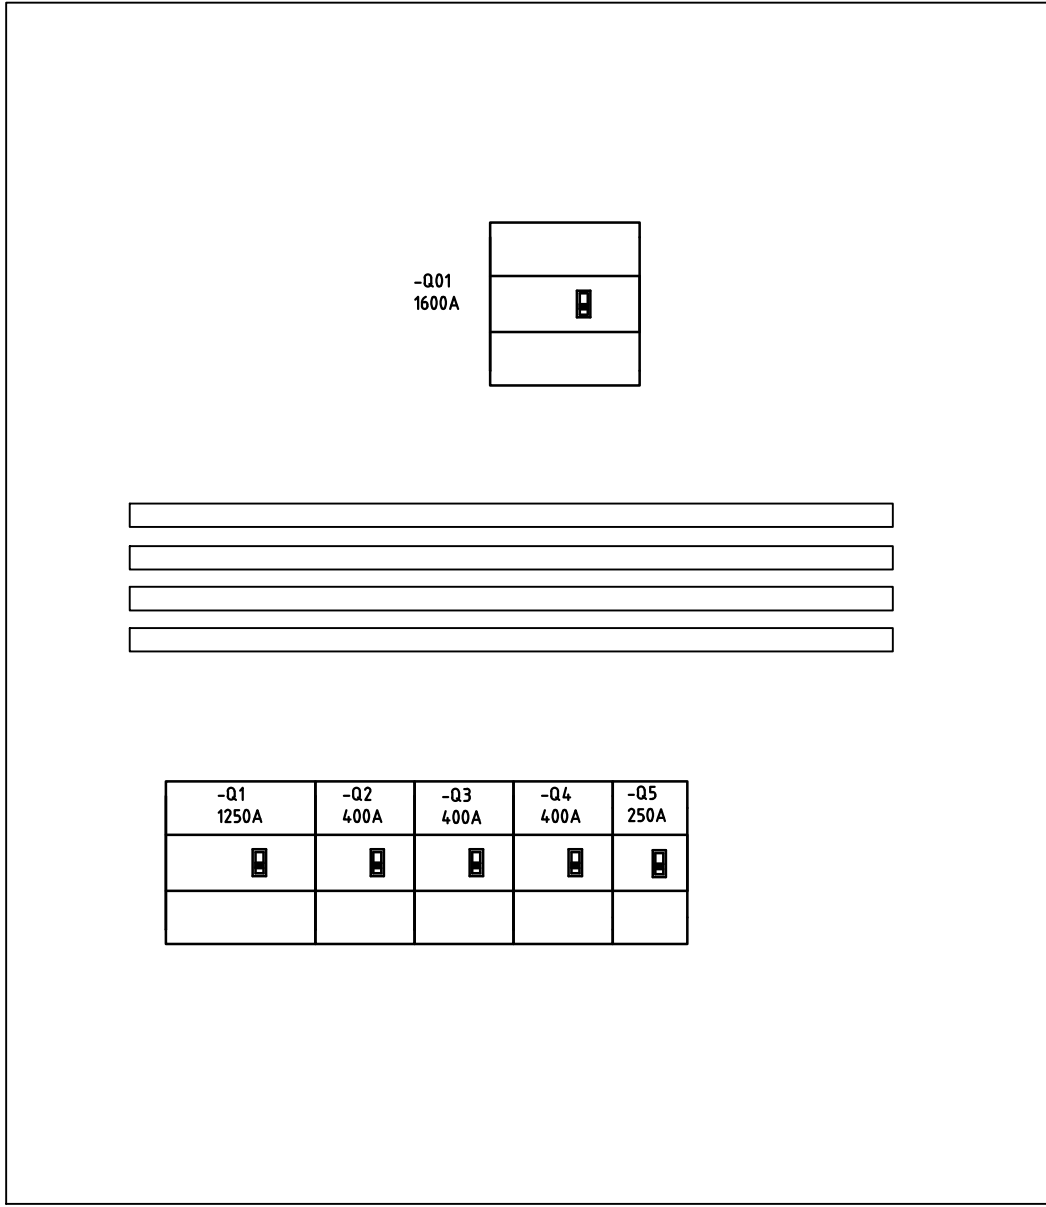

B	ASBUILT		ES	ES
A	PROOUKSJON		ES	ES
REV.	DESCRIPTION	DATE	DWN	REV.SIGN

**SATEMA**

OSLO                      MOELV  
Tlf.22 57 93 00          Tlf.62 33 44 30


Ramirent AB  
SAT(ON TAF 1000kVA  
Ombygging av 65242  
22/11kV//1kV 50Hz

JOB NUMBER 65242		DRAWING NUMBER 65242		
DRAWN	ES	DESIGNED	ES	APPROVED
PAPER SIZE	A4	SCALE		SHEET 1X01
DATE	05.01.2007	REV.	05.01.2007	CONT SH.

A  
B  
C  
D  
E  
F  
G  
H

SAMLESKINNER

SAMLESKINNER

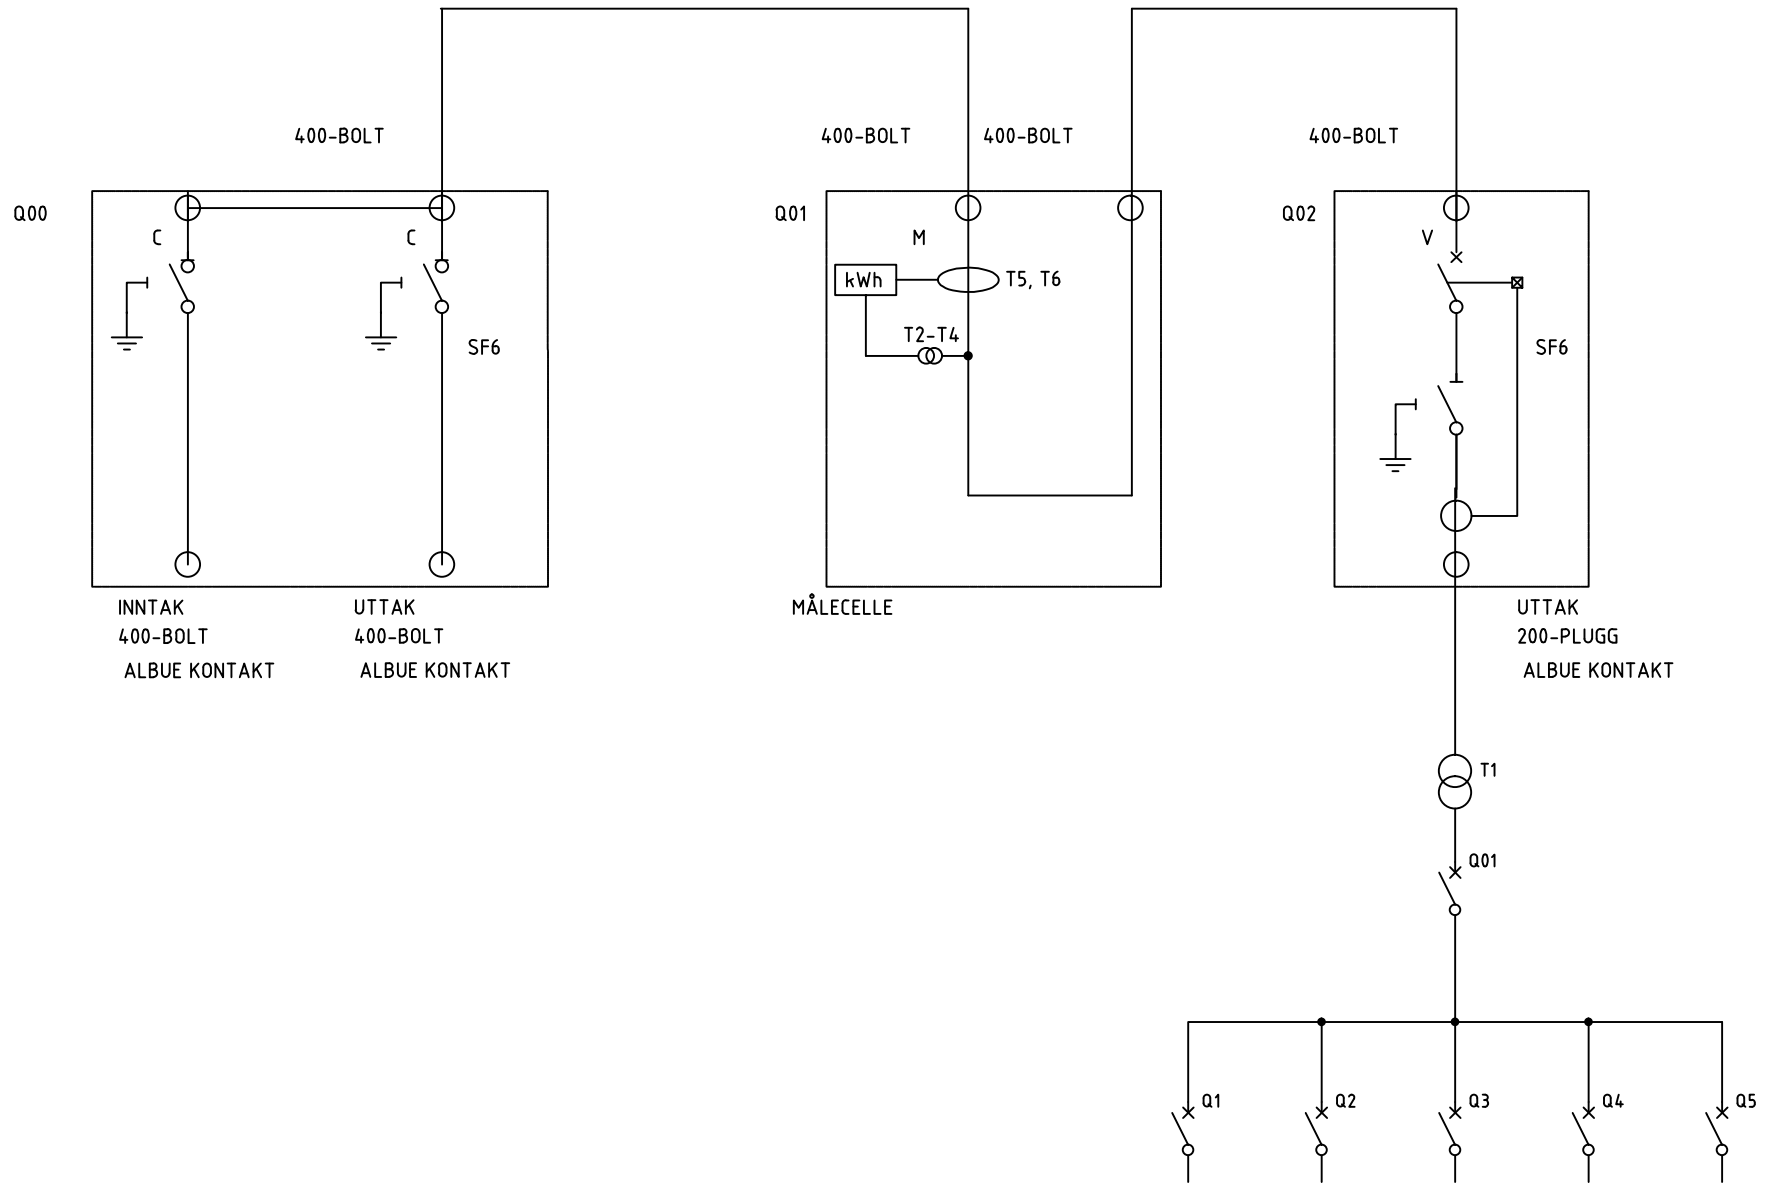


B	ASBUILT		ES	ES
A	PROOUKSJON		ES	ES
REV.	DESCRIPTION	DATE	DWN	REV.SIGN



OSLO Tlf.22 57 93 00  
MOELV Tlf.62 33 44 30

Ramirent AB  
SAT(ON TAF 1000kVA  
Ombygging av 65242  
22/11kV//11kV 50Hz

JOB NUMBER 65242		DRAWING NUMBER 65242		
DRAWN	ES	DESIGNED	ES	APPROVED
PAPER SIZE	A4	SCALE		SHEET 1X01
DATE	05.01.2007	REV.	05.01.2007	CONT. SH.

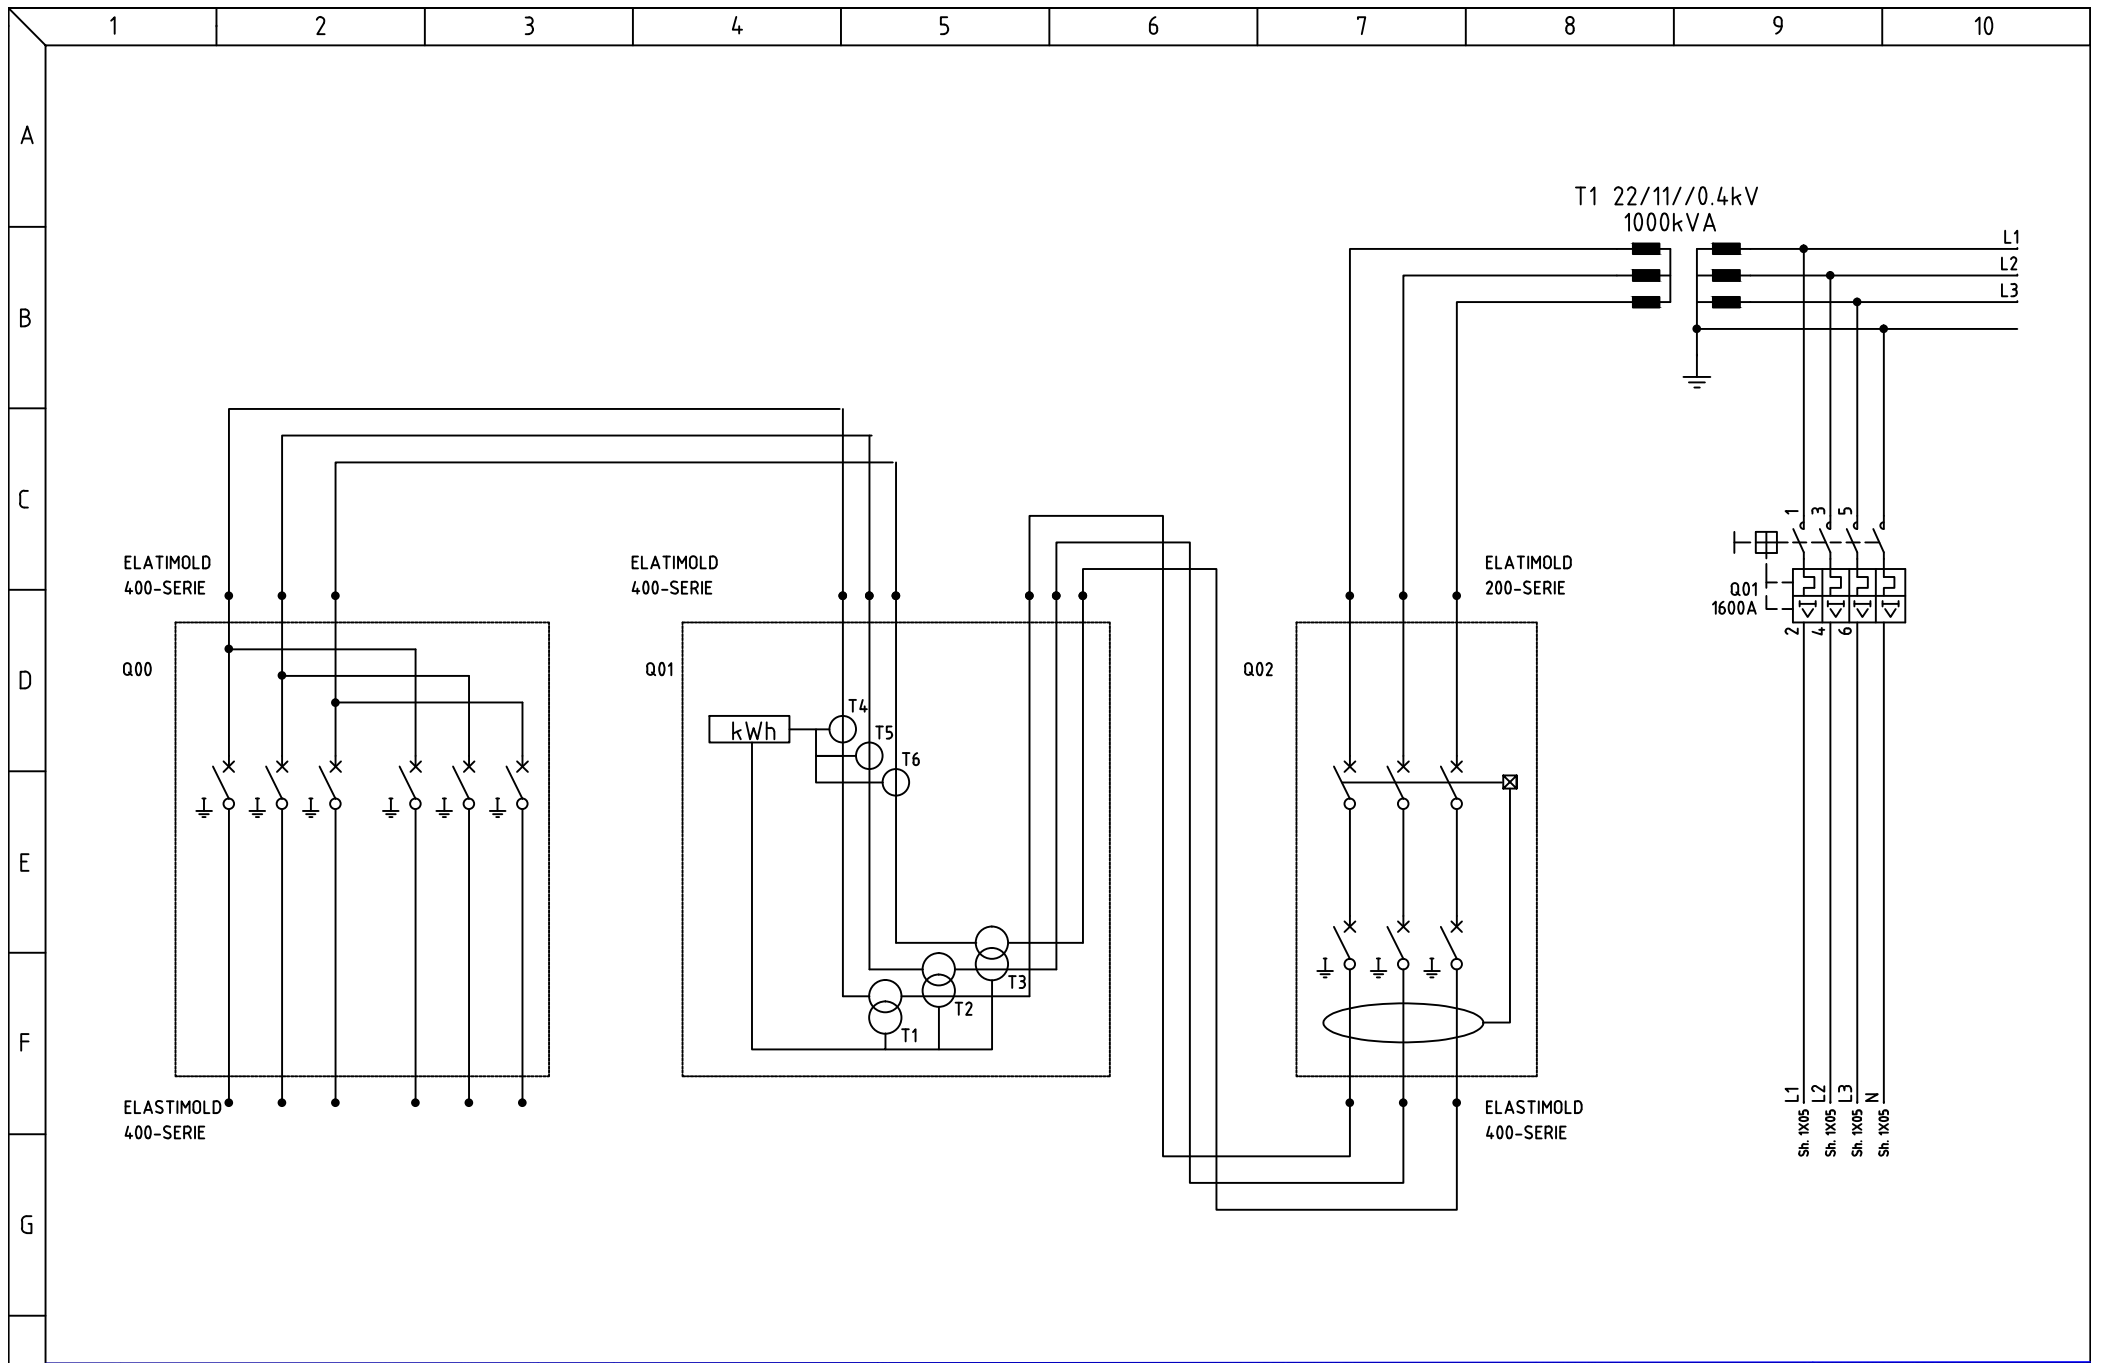


B	ASBUILT		ES	ES
A	PROOUKSJON		ES	ES
REV.	DESCRIPTION	DATE	DWN	REV.SIGN

**SATEMA**

OSLO                      MOELV  
Tlf.22 57 93 00              Tlf.62 33 44 30

Ramirent AB  
SAT(ON TAF 1000kVA  
Ombygging av 65242  
22/11kV//1kV 50Hz

JOB NUMBER 65242		DRAWING NUMBER 65242		
DRAWN	ES	DESIGNED	ES	APPROVED
PAPER SIZE	A4	SCALE		SHEET 1X01
DATE	05.01.2007	REV.	05.01.2007	CONT SH.

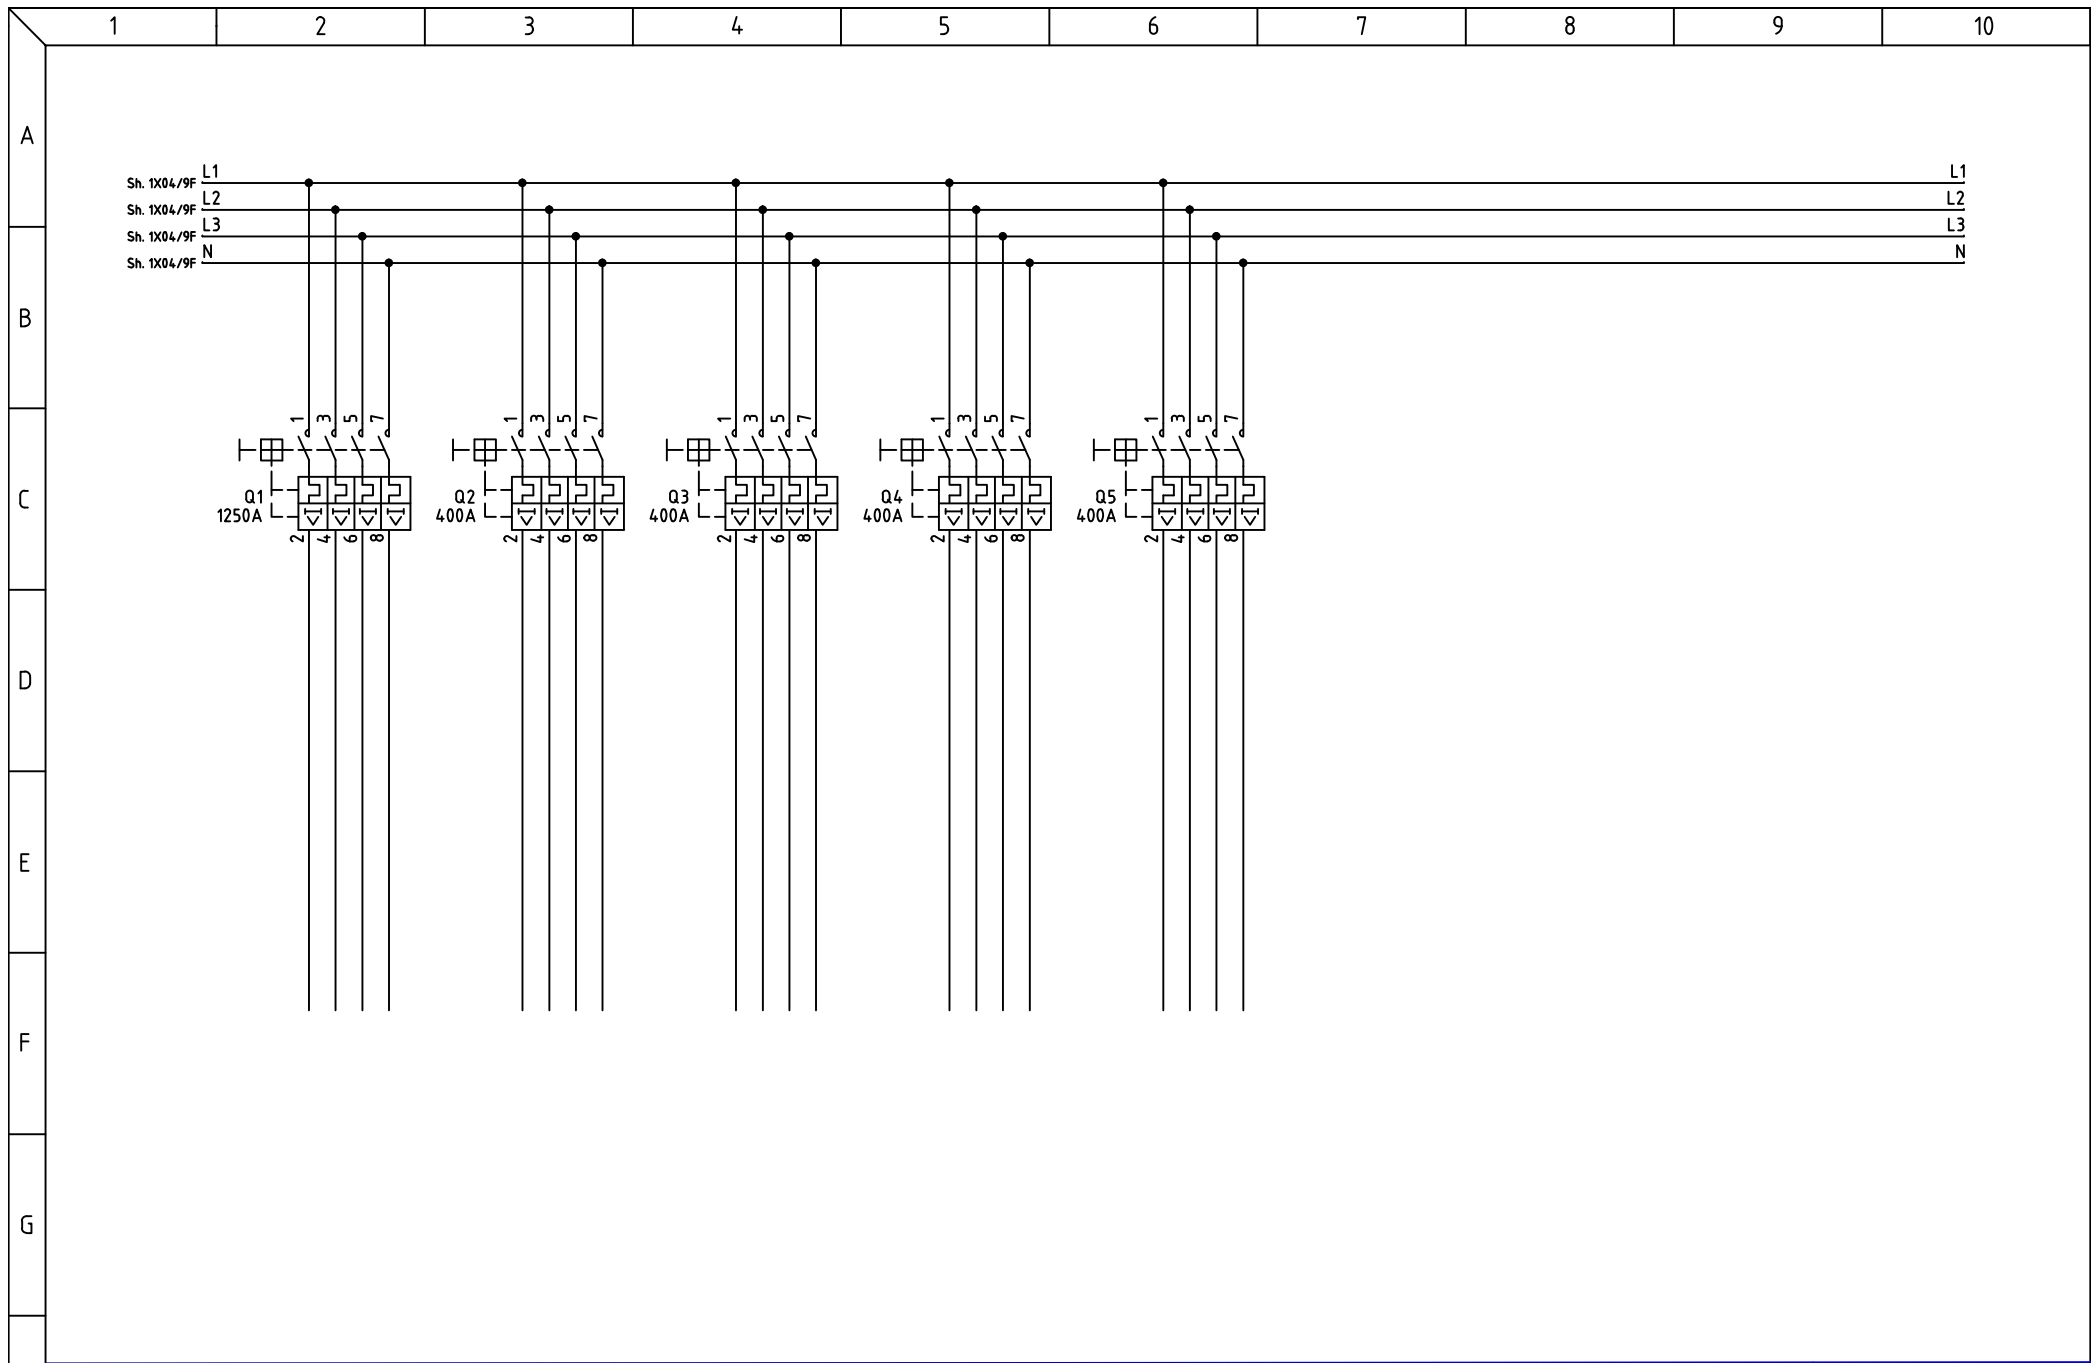


B	ASBUILT		ES	ES
A	PROOVSJON		ES	ES
REV.	DESCRIPTION	DATE	DWN	REV.SIGN



OSLO                      MOELV  
Tlf.22 57 93 00        Tlf.62 33 44 30

Ramirent AB  
SAT(ON TAF 1000kVA  
Ombygging av 65242  
22/11kV//1kV 50Hz

JOB NUMBER 65242		DRAWING NUMBER 65242		
DRAWN	ES	DESIGNED	ES	APPROVED
PAPER SIZE	A4	SCALE		SHEET 1X01
DATE	05.01.2007	REV.	05.01.2007	CONT SH.

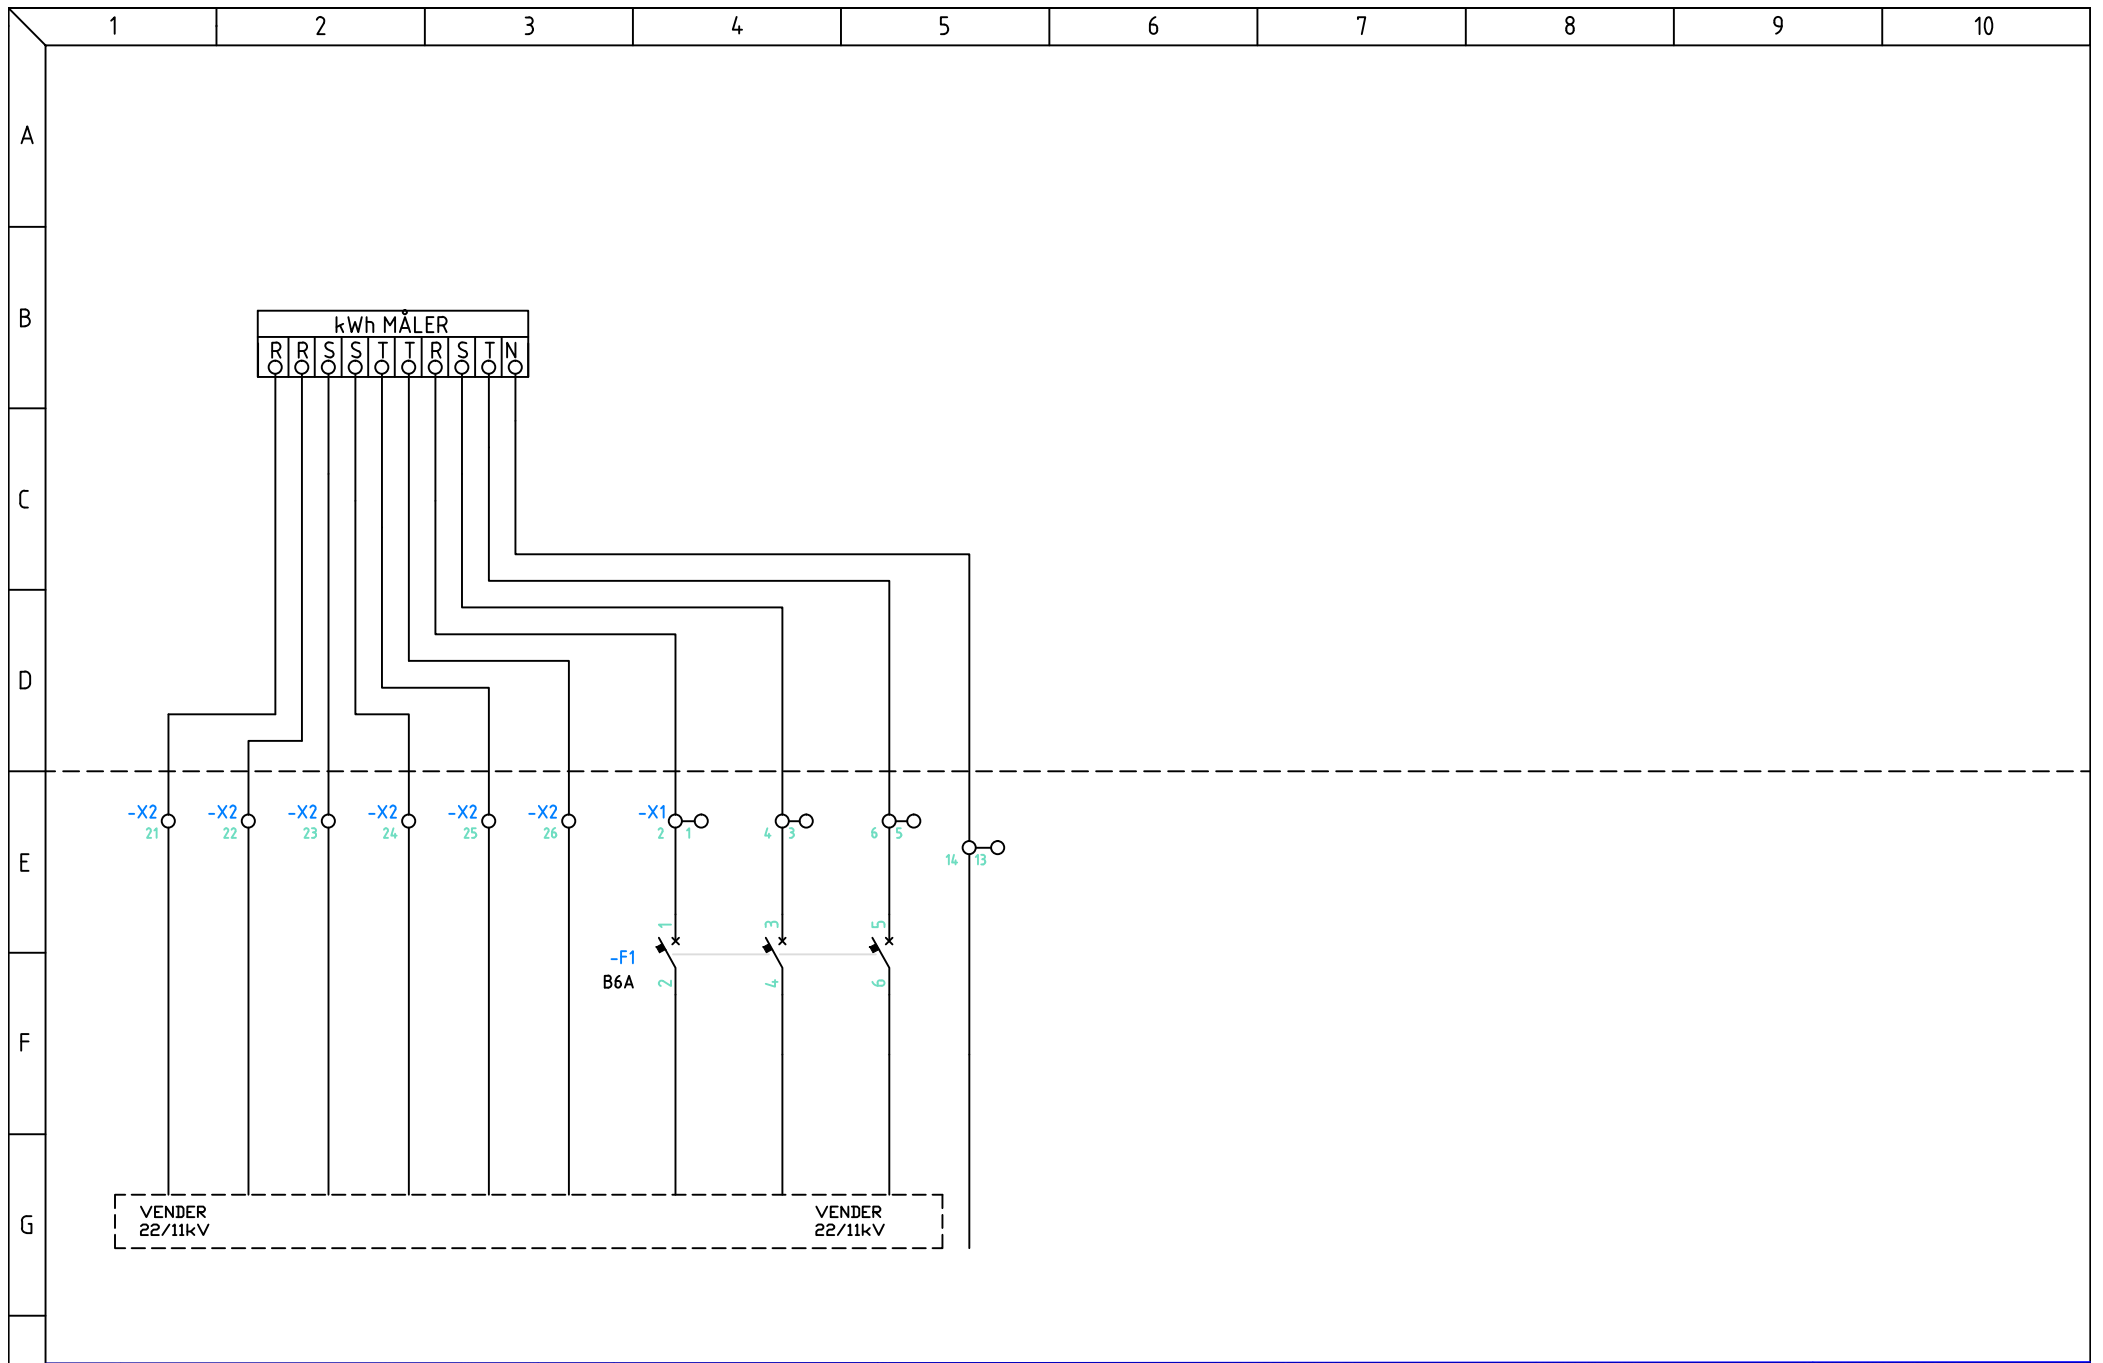

B	ASBUILT		ES	ES
A	PROOVSJON		ES	ES
REV.	DESCRIPTION	DATE	DWN	REV.SIGN



OSLO MOELV  
Tlf.22 57 93 00 Tlf.62 33 44 30

Ramirent AB  
SAT(ON TAF 1000kVA  
Ombygging av 65242  
22/11kV//1kV 50Hz

JOB NUMBER 65242		DRAWING NUMBER 65242		
DRAWN	ES	DESIGNED	ES	APPROVED
PAPER SIZE	A4	SCALE		SHEET 1X01
DATE	05.01.2007	REV.	05.01.2007	CONT SH.



- C1
- C2
- C3
- C4
- C5

POWER

50Hz

CURVE     60Hz

	CT1 TERMINAL	CT2 TERMINAL		
	S0-S1	S0-S2	S0-S1	S0-S2
<input type="checkbox"/> In a	14.4	41.1	117.4	335
<input type="checkbox"/> In b	18.7	53.4	152.7	436
<input type="checkbox"/> In c	24.3	69.5	198.5	566
<input type="checkbox"/> In d	31.6	90.3	258	737



I <sub>o</sub> > / I <sub>n</sub>			
<input checked="" type="checkbox"/> <input checked="" type="checkbox"/> <input checked="" type="checkbox"/> <input checked="" type="checkbox"/>	0.10	<input type="checkbox"/> <input type="checkbox"/> <input type="checkbox"/> <input type="checkbox"/>	0.60
<input type="checkbox"/> <input type="checkbox"/> <input type="checkbox"/> <input type="checkbox"/>	0.20	<input type="checkbox"/> <input type="checkbox"/> <input type="checkbox"/> <input type="checkbox"/>	0.65
<input type="checkbox"/> <input type="checkbox"/> <input type="checkbox"/> <input type="checkbox"/>	0.25	<input type="checkbox"/> <input type="checkbox"/> <input type="checkbox"/> <input type="checkbox"/>	0.70
<input type="checkbox"/> <input type="checkbox"/> <input type="checkbox"/> <input type="checkbox"/>	0.30	<input type="checkbox"/> <input type="checkbox"/> <input type="checkbox"/> <input type="checkbox"/>	0.80
<input type="checkbox"/> <input type="checkbox"/> <input type="checkbox"/> <input type="checkbox"/>	0.35	<input type="checkbox"/> <input type="checkbox"/> <input type="checkbox"/> <input type="checkbox"/>	0.90
t<sub>o</sub> > [s]

1072/ 103